


91.99'

S 87°44'03" W

EXIST. GRASS SWALE

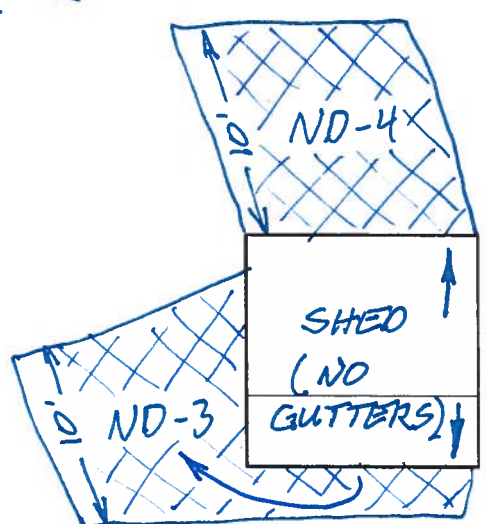

139.00'

S 0°00'00" E

PROPOSED GRASS SWALE

50' x 2'

50' x 2'


50' x 2'

50' x 2'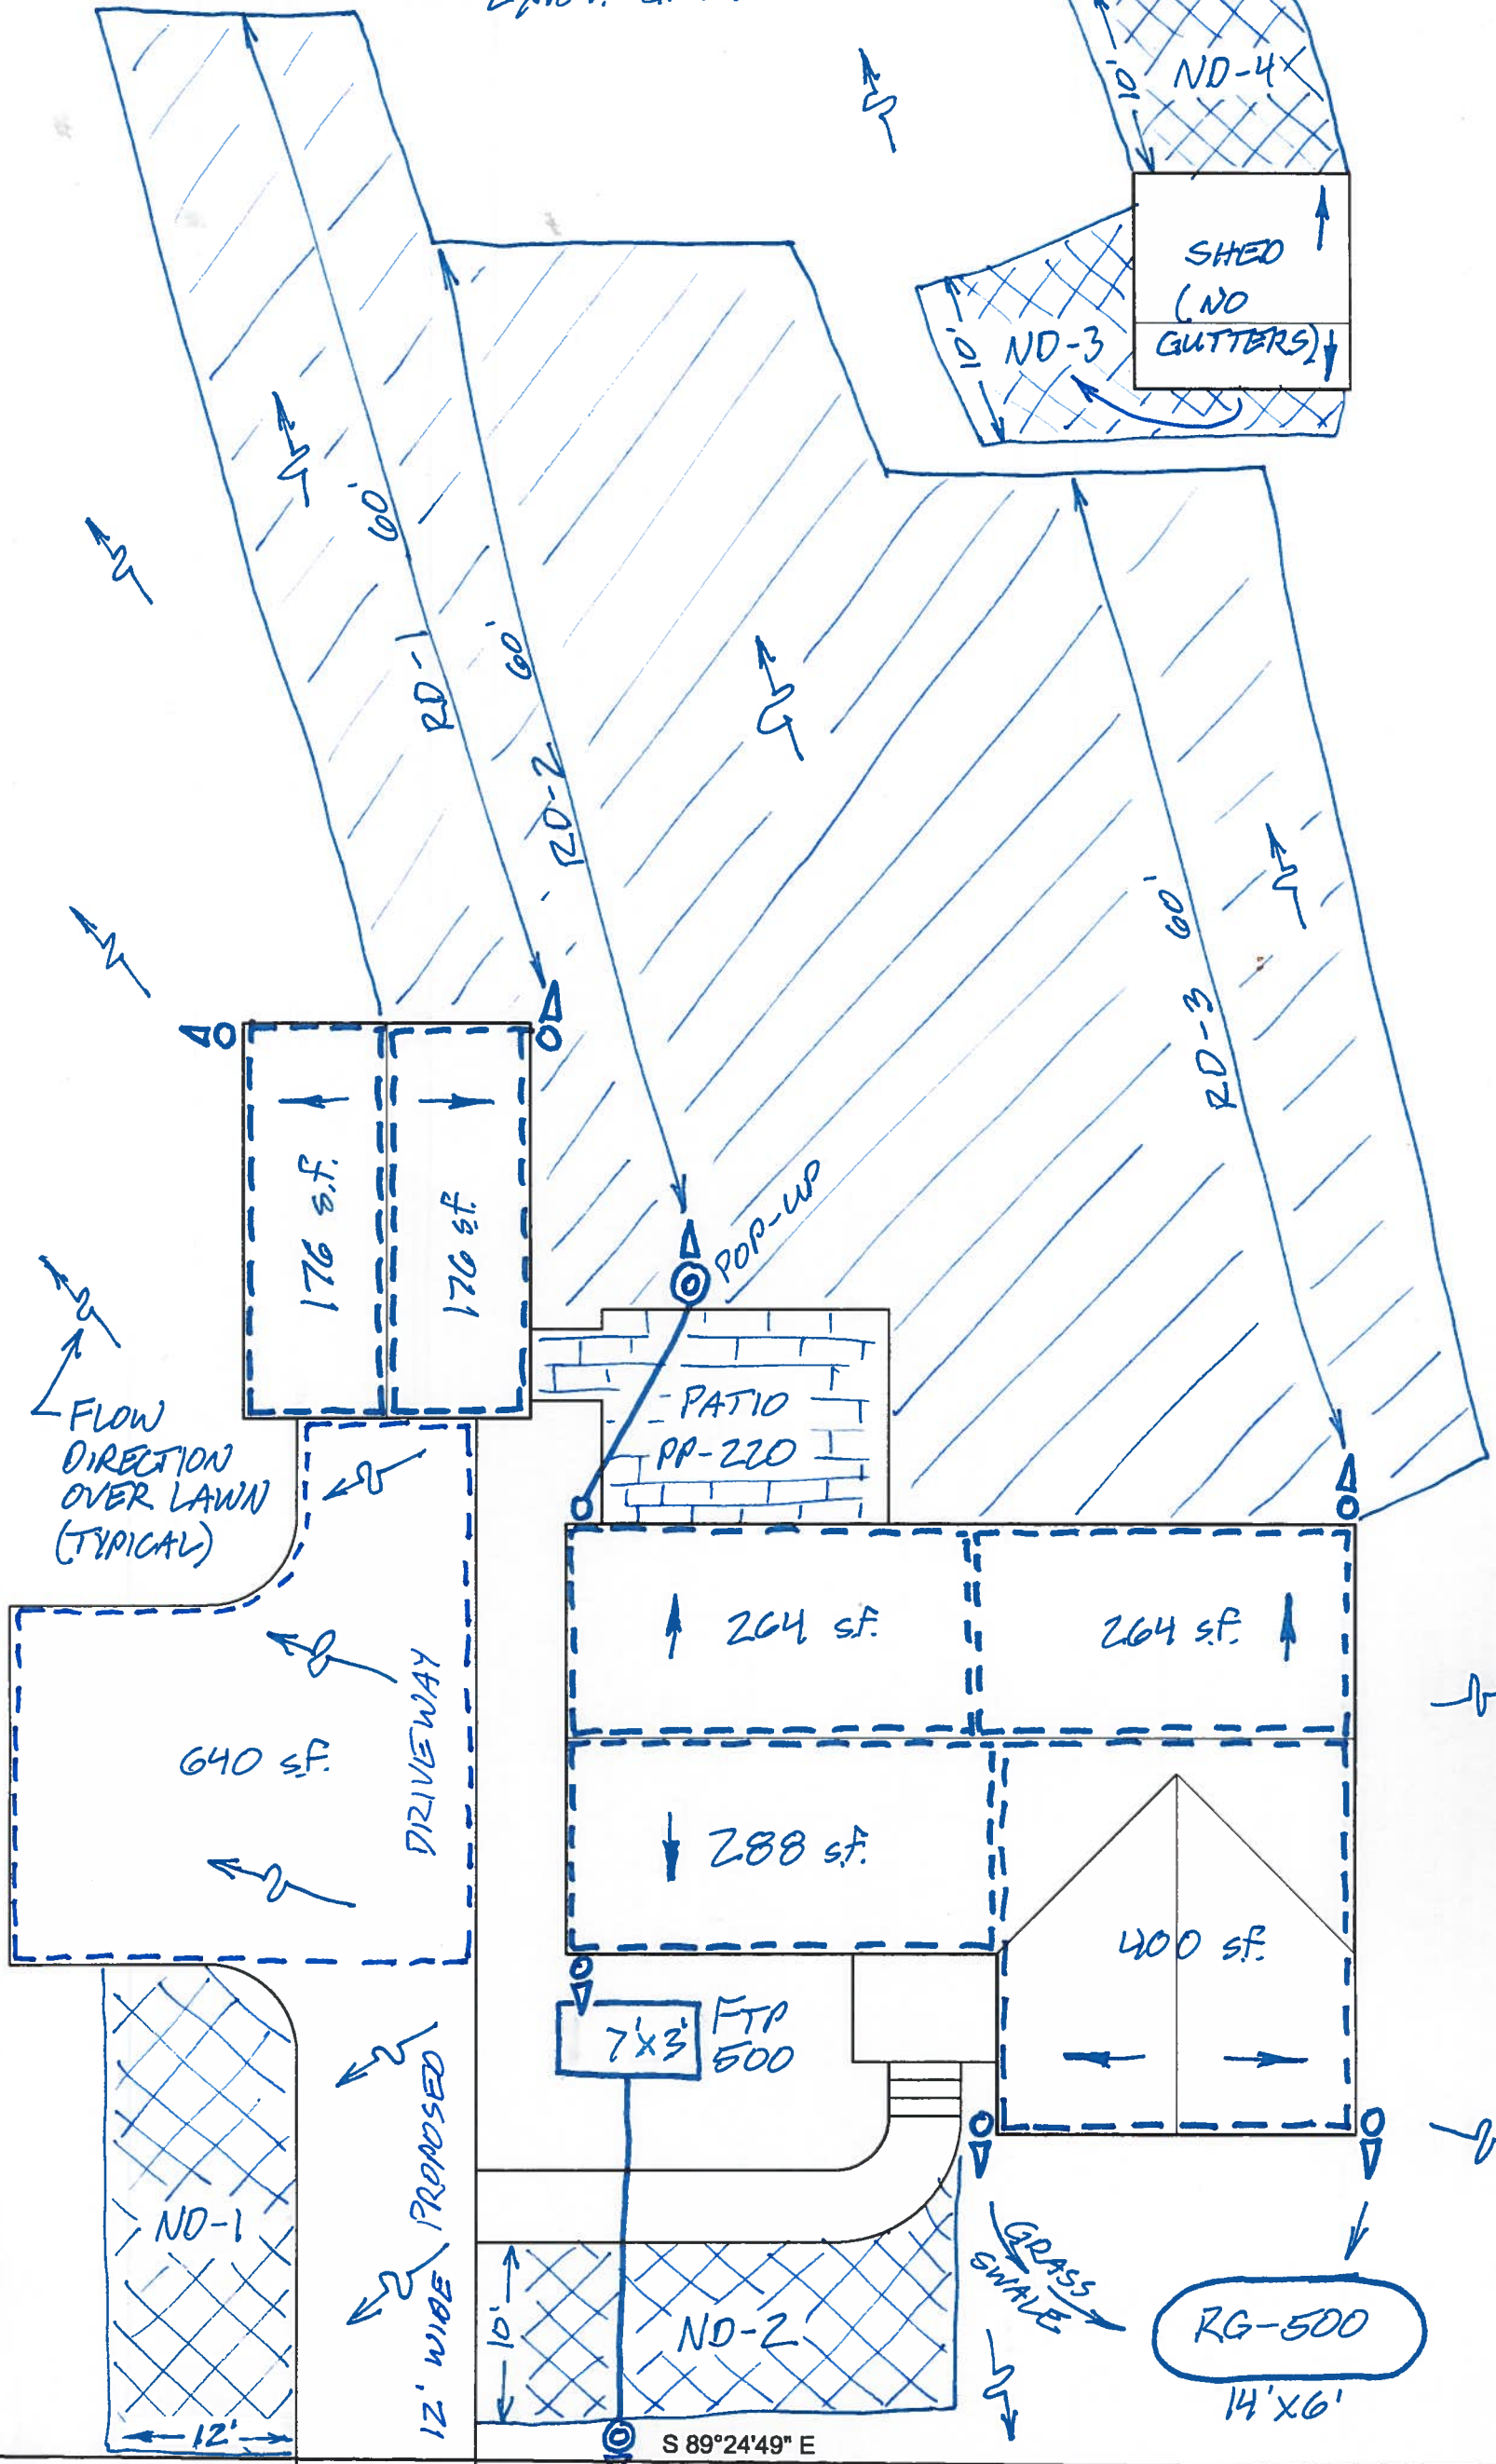

FLOW DIRECTION OVER LAWN (TYPICAL)

DRIVEWAY

POP-UP

PATIO PP-220

7' x 3' FTP 500

ND-2

S 89°24'49" E 98.36'

POP-UP

GRASS SWALE

RG-500 14' x 6'

EXIST. ROADSIDE DITCH

EXIST. EDGE OF PAVEMENT

18" DRIVE CULVERT

STANDARD SWM PLAN - EXAMPLE MARKUP

SCALE: 1" = 10' (IF PRINTED ON 11x17)

N 2°33'59" W

143.79'